
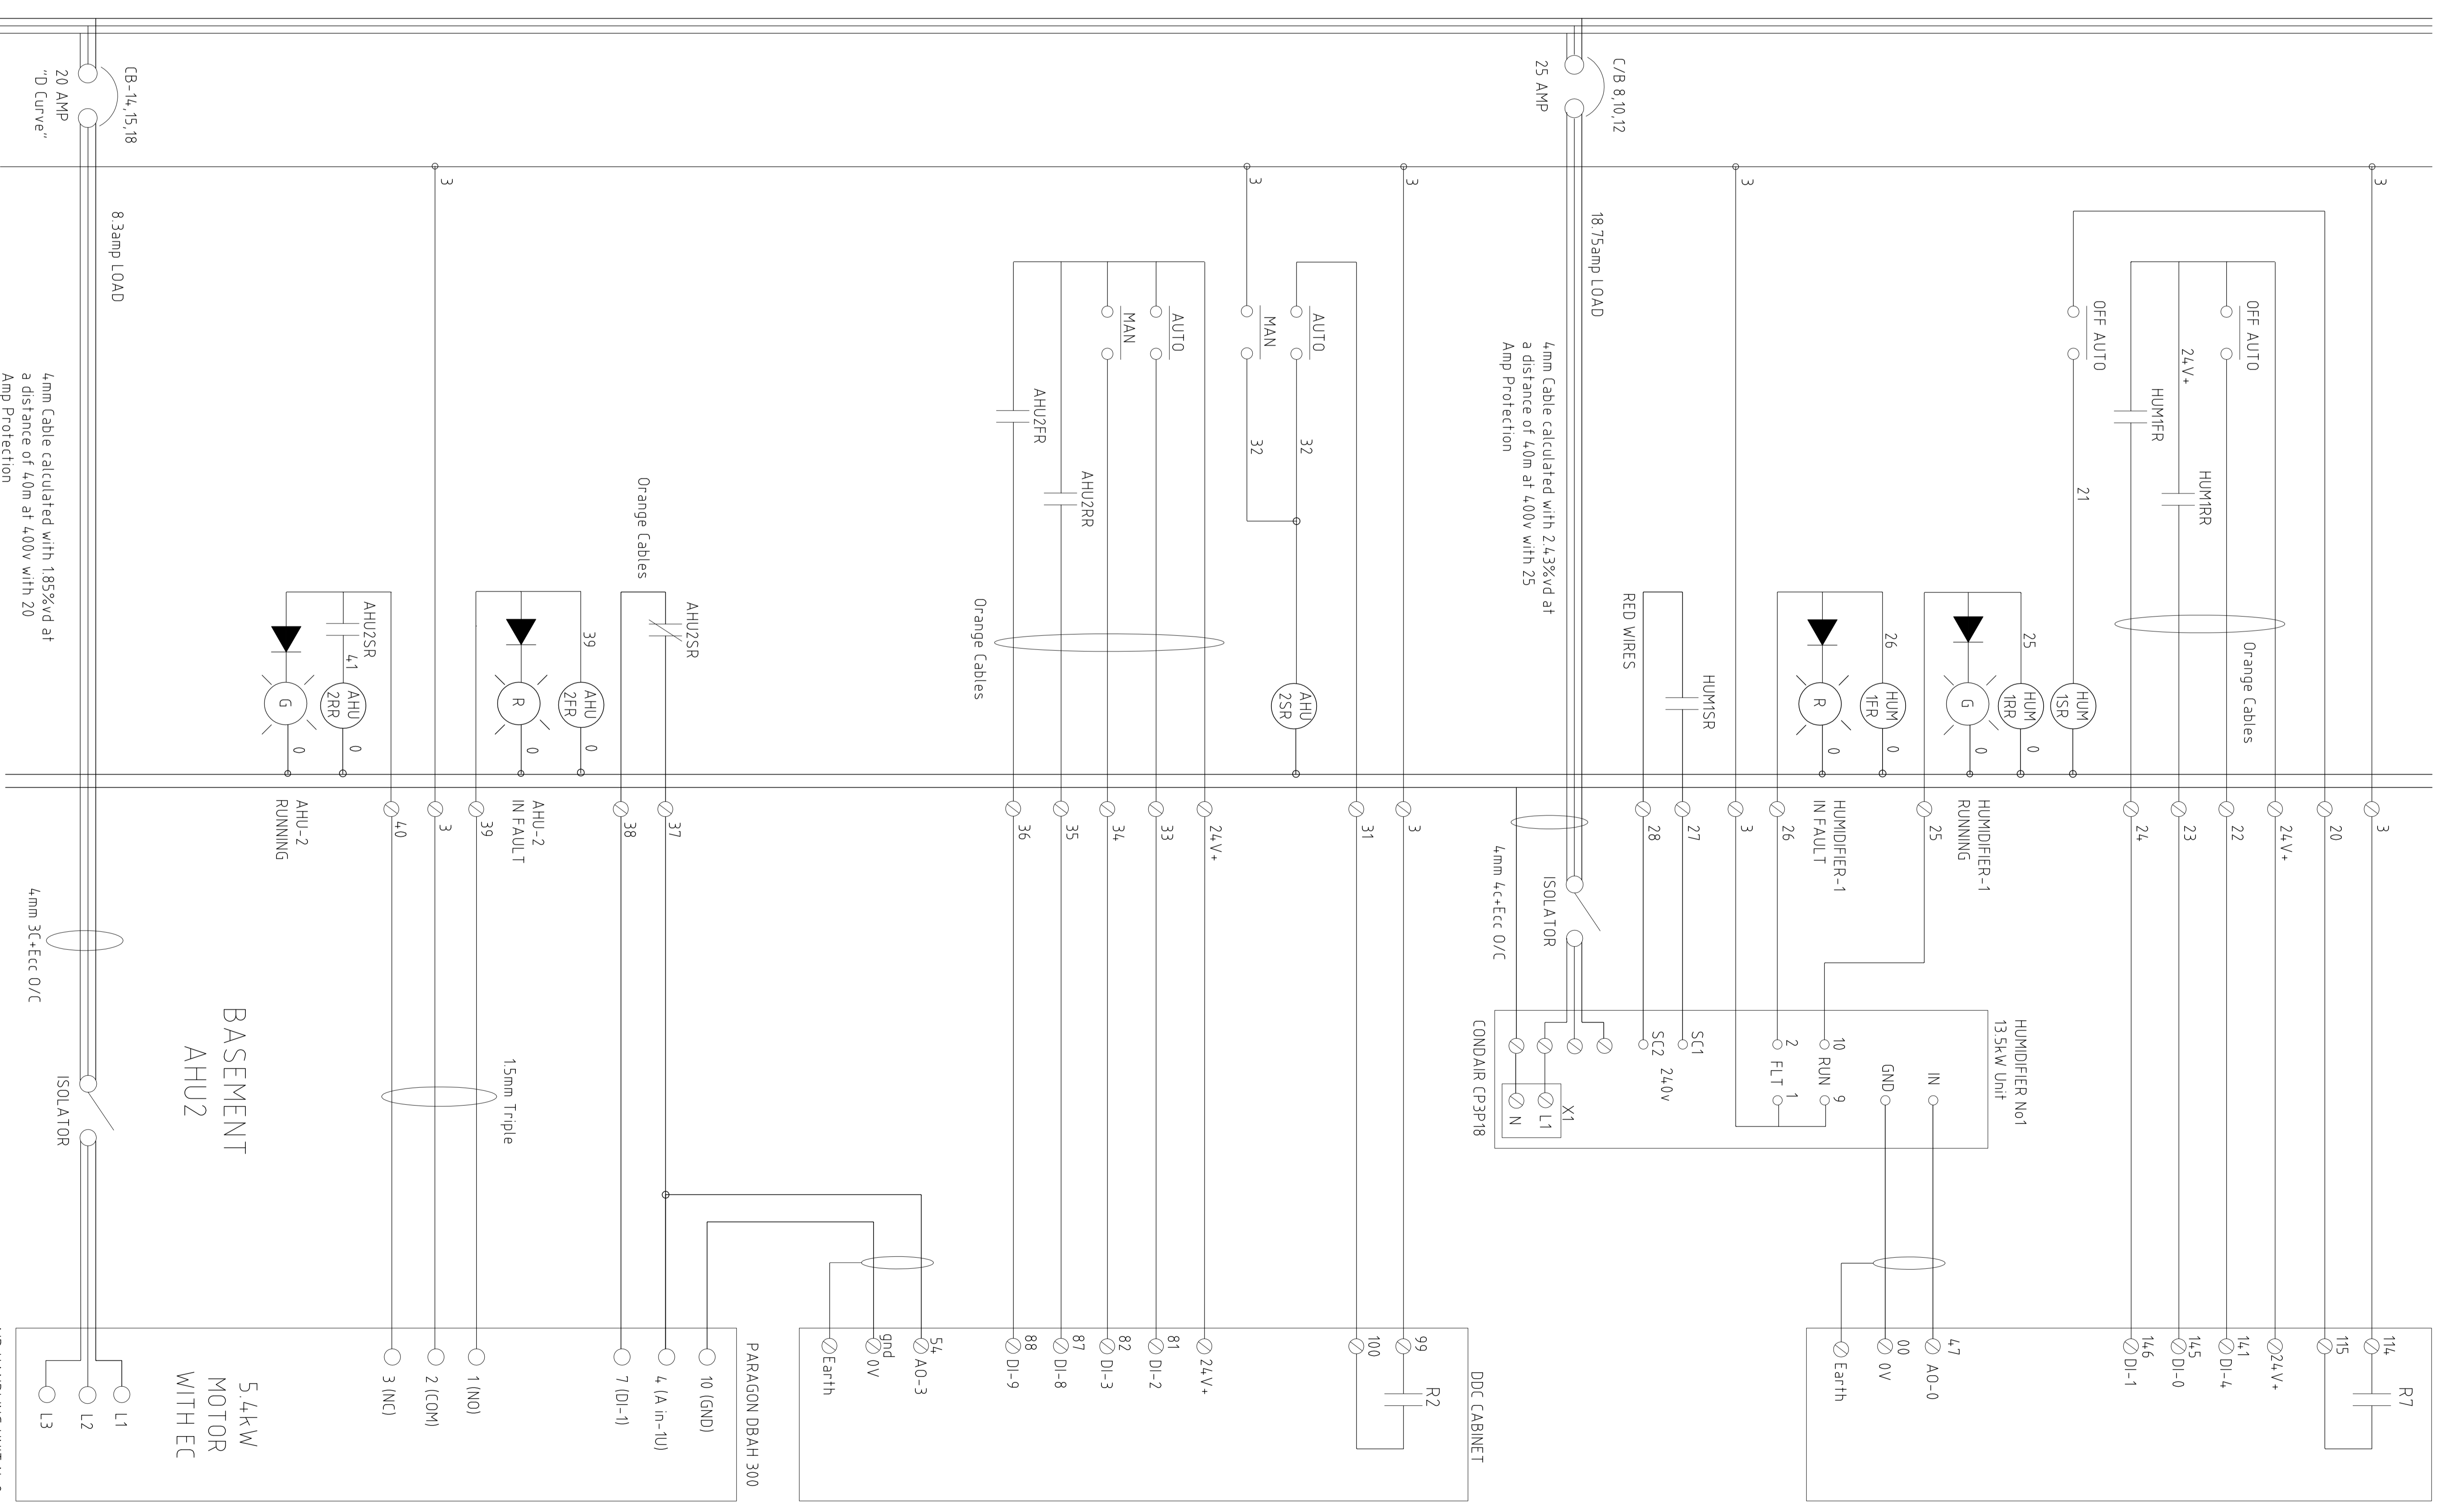


CALCULATED LOAD TO BE  
232 Amps per phase

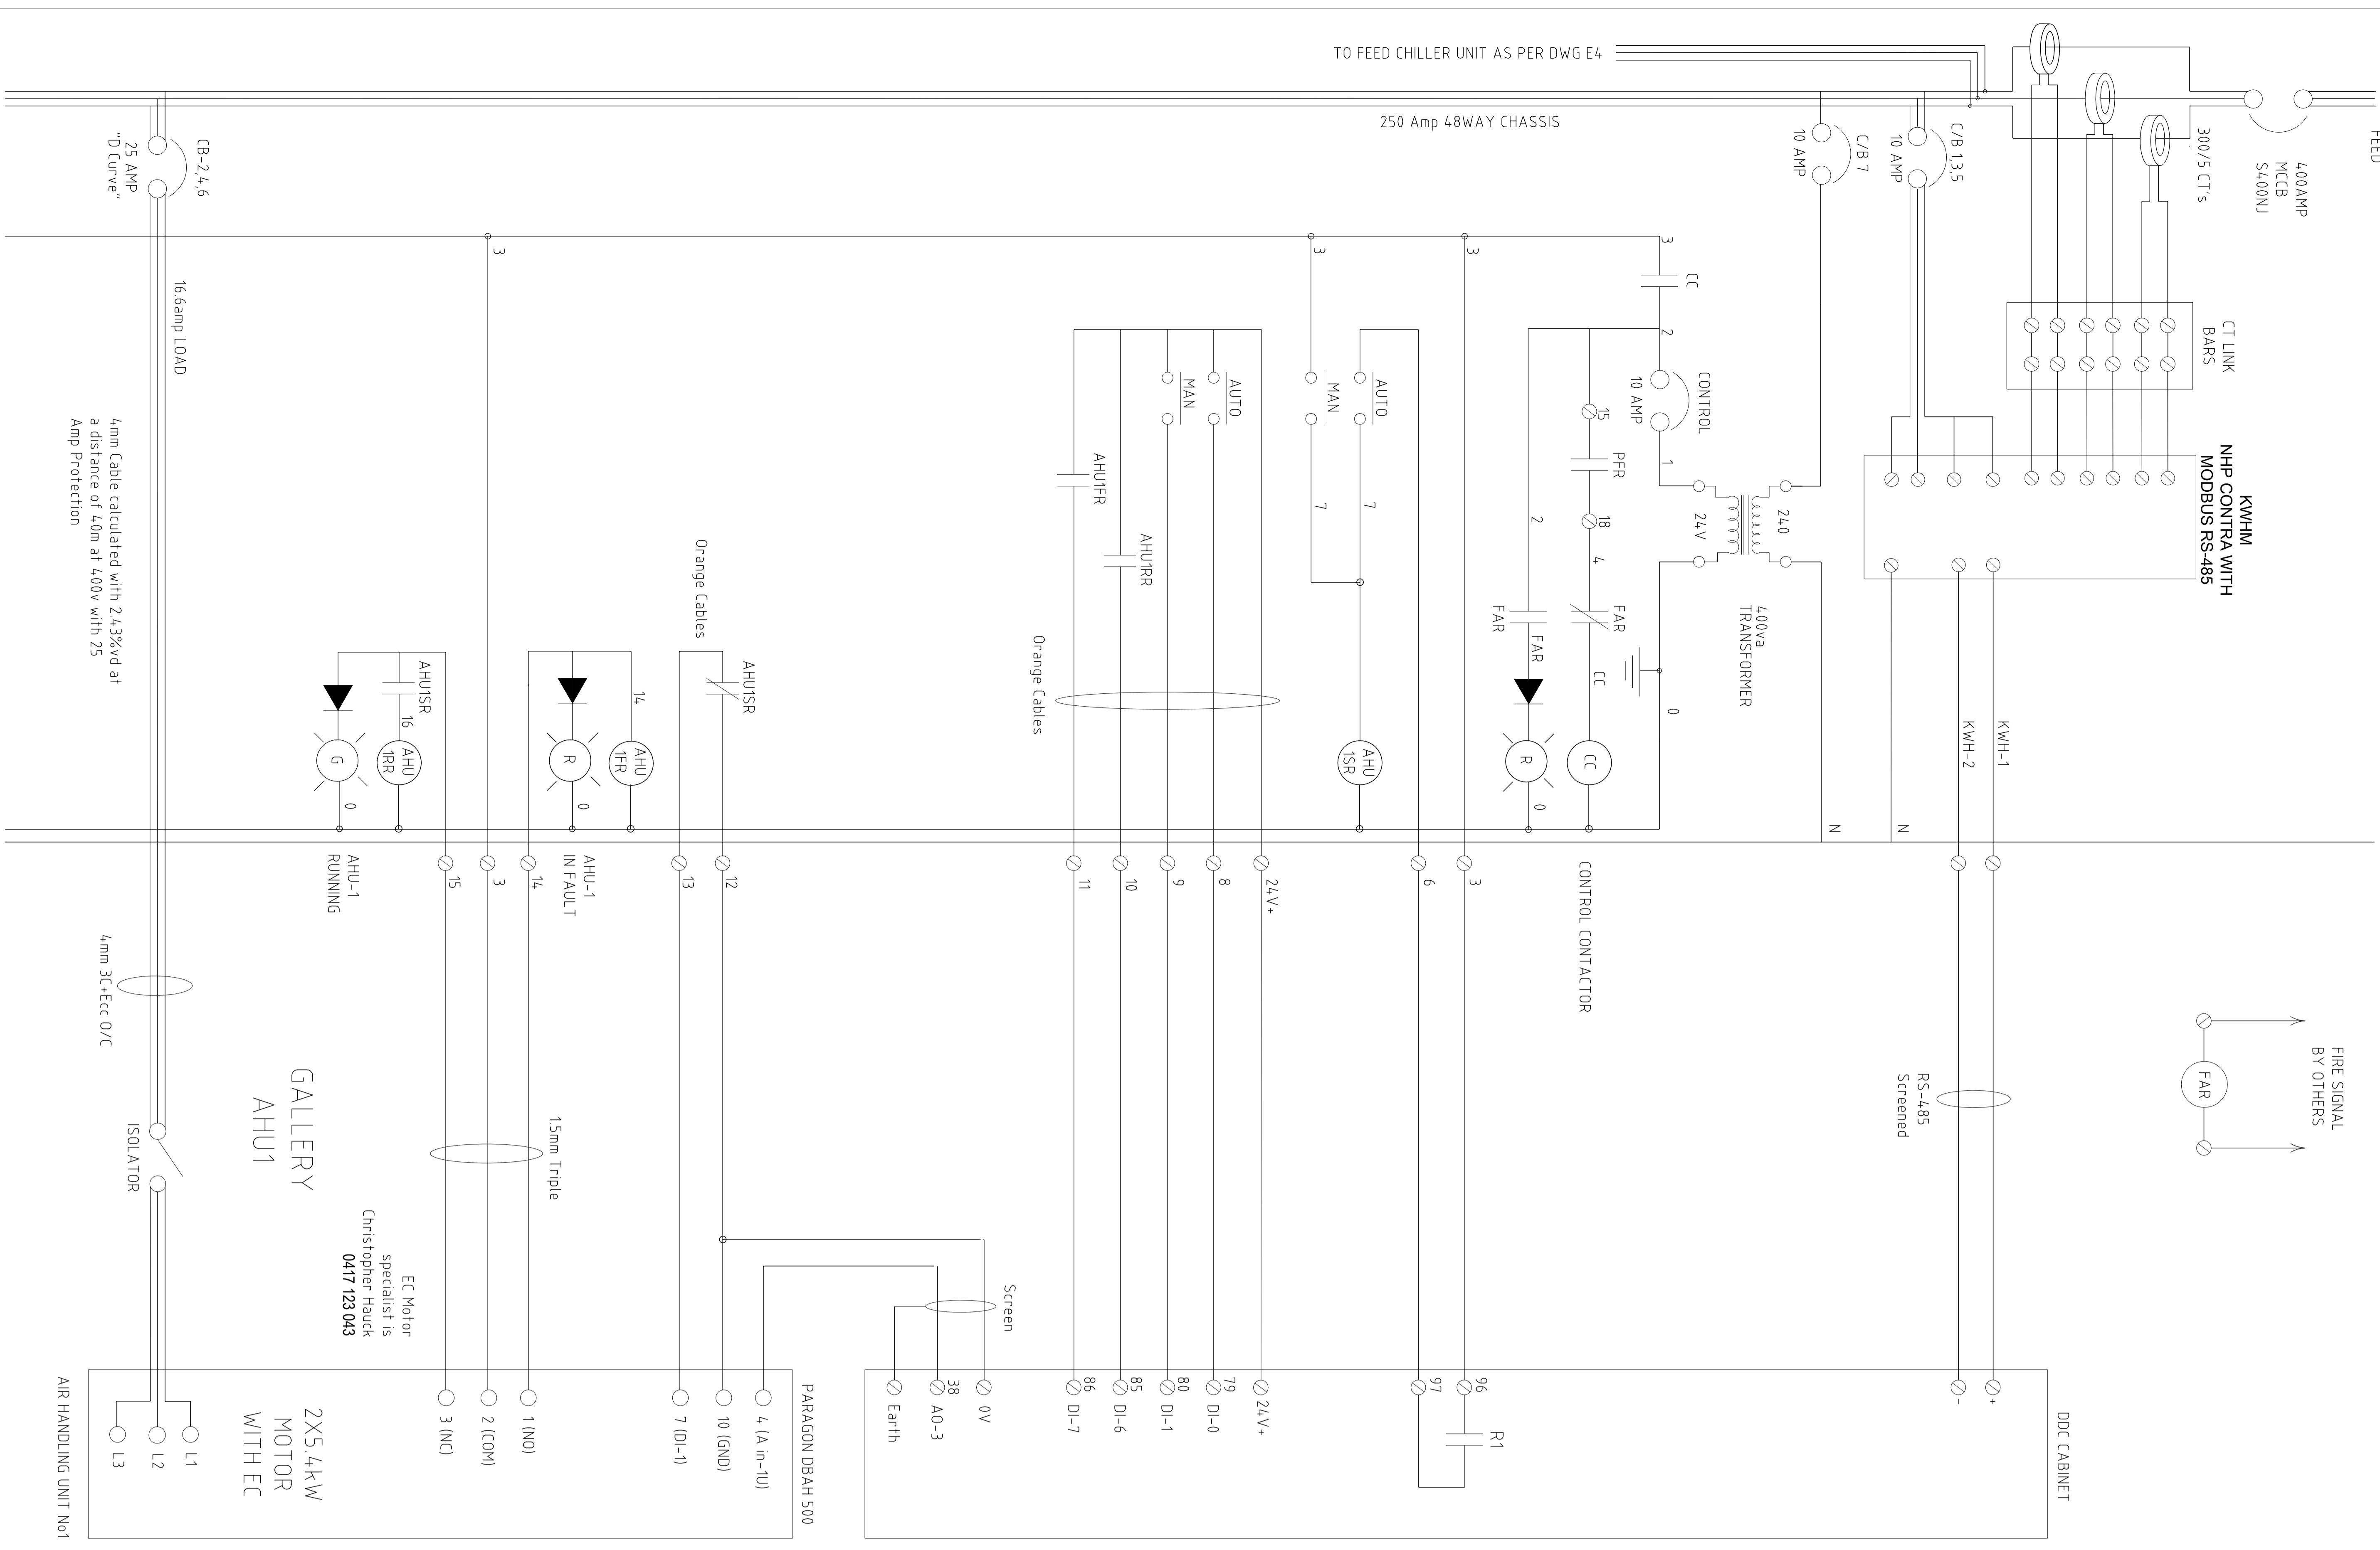

ELECTRICAL SYMBOL SCHEDULE

	TRANSFORMER OPEN TYPE
	RUNNING INDICATOR
	FAULT INDICATOR
	PUSH-BUTTON
	NORMALLY OPEN RELAY / CONTACTOR CONTACTS
	NORMALLY CLOSED RELAY / CONTACTOR CONTACTS
	FIELD TERMINALS
	AUTO-OFF-MANUAL PANEL SWITCH
	CIRCUIT BREAKER
	RELAY / CONTACTOR COIL
	OFF-ON PANEL SWITCH
	TIME CLOCK COIL
	ELECTRIC MOTOR 3 PHASE
	FIELD ISOLATOR
	STARTER CONTACTOR + OVERLOAD
	THERMOSTAT IN FIELD
	FIELD SENSOR

DATE 18th Oct 2012 DESIGNED RR  
SCALE N/A CHECKED  
DRAWN RR No. IN SET 1 of 7

CONTROL & DESIGN PTY LTD  
52 TAYLORS LANE STRATHFIELD  
TEL. (03) 54393495 FAX. (03) 54395126  
ACN. 086698679

PROJECT  
BENDIGO ART GALLERY EXTENSION  
VIEW STREET BENDIGO VICTORIA

TITLE  
MECHANICAL ELECTRICAL  
SERVICES BOARD No 5  
ELECTRICAL SCHEMATIC  
BENDIGO ART GALLERY  
AS BUILT DRAWINGS

DRAWING No. C-438 E1  
CAD FILE No. DWG5/BENDIGO ART GALLERY/ELEC SCHEMATIC  
REVISION 2