
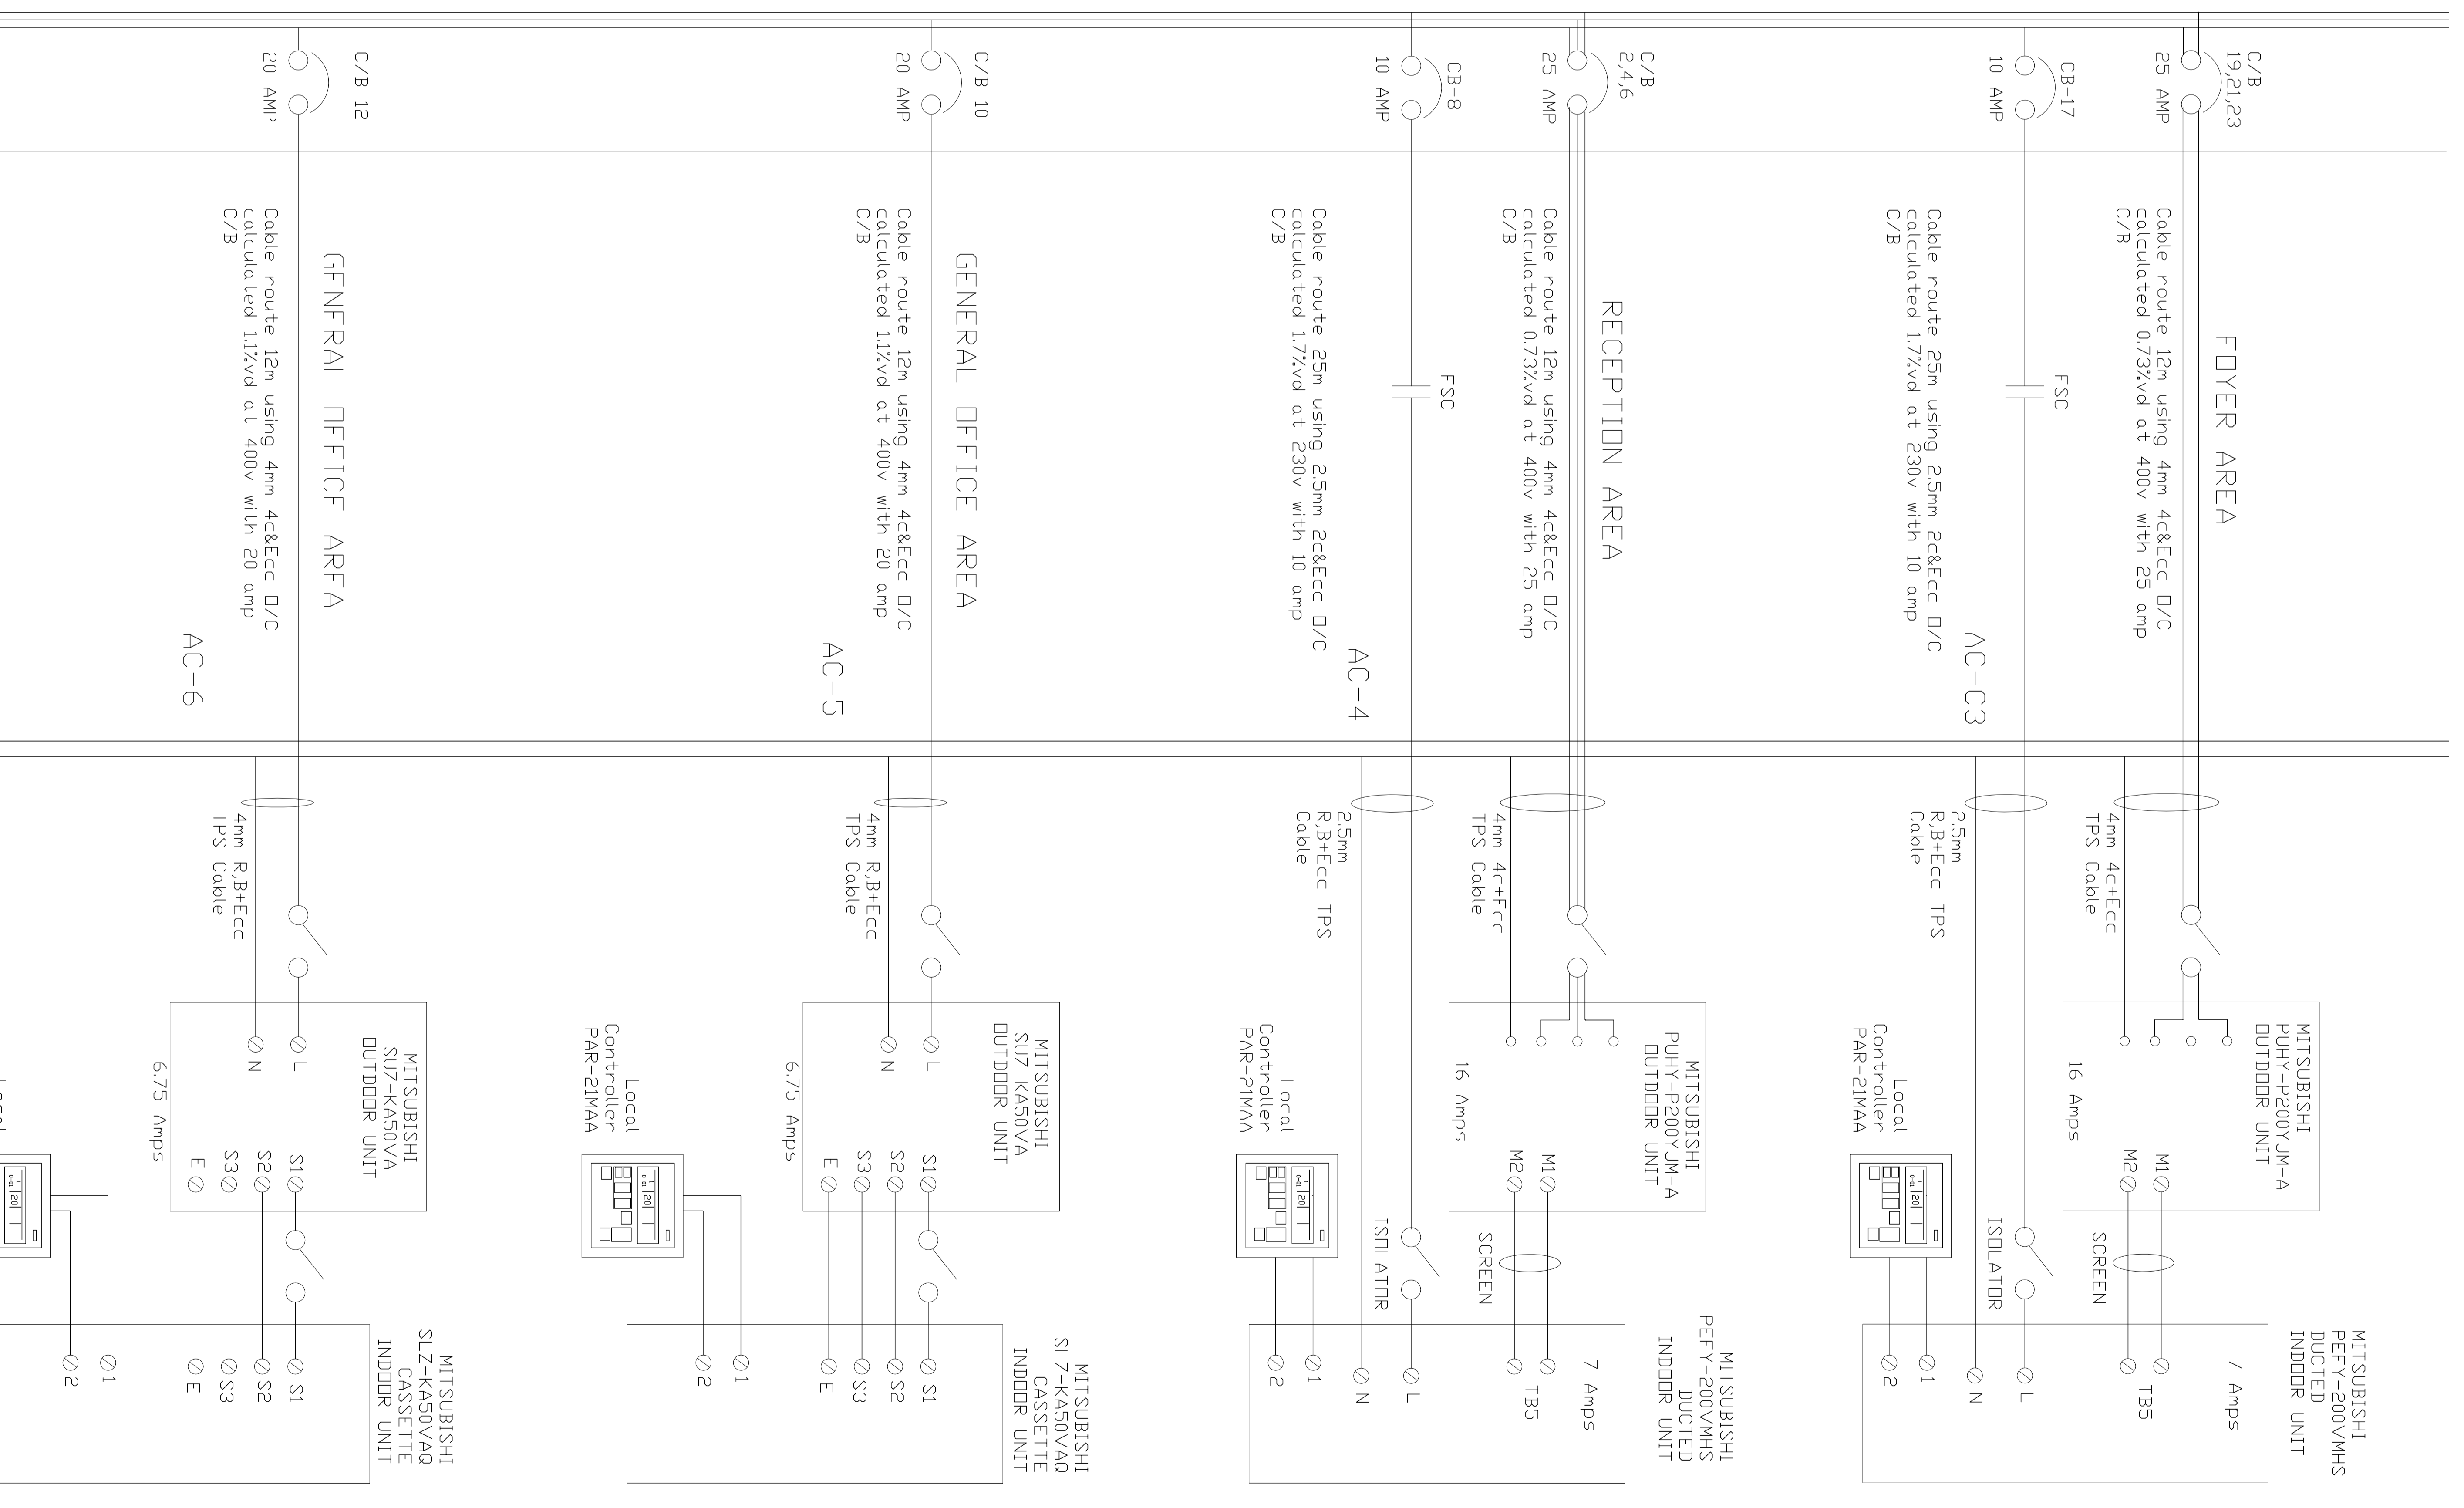


Total estimated load for this MSSB is
 Red Phase 84 amps
 White Phase 84 amps
 Blue Phase 84 amps

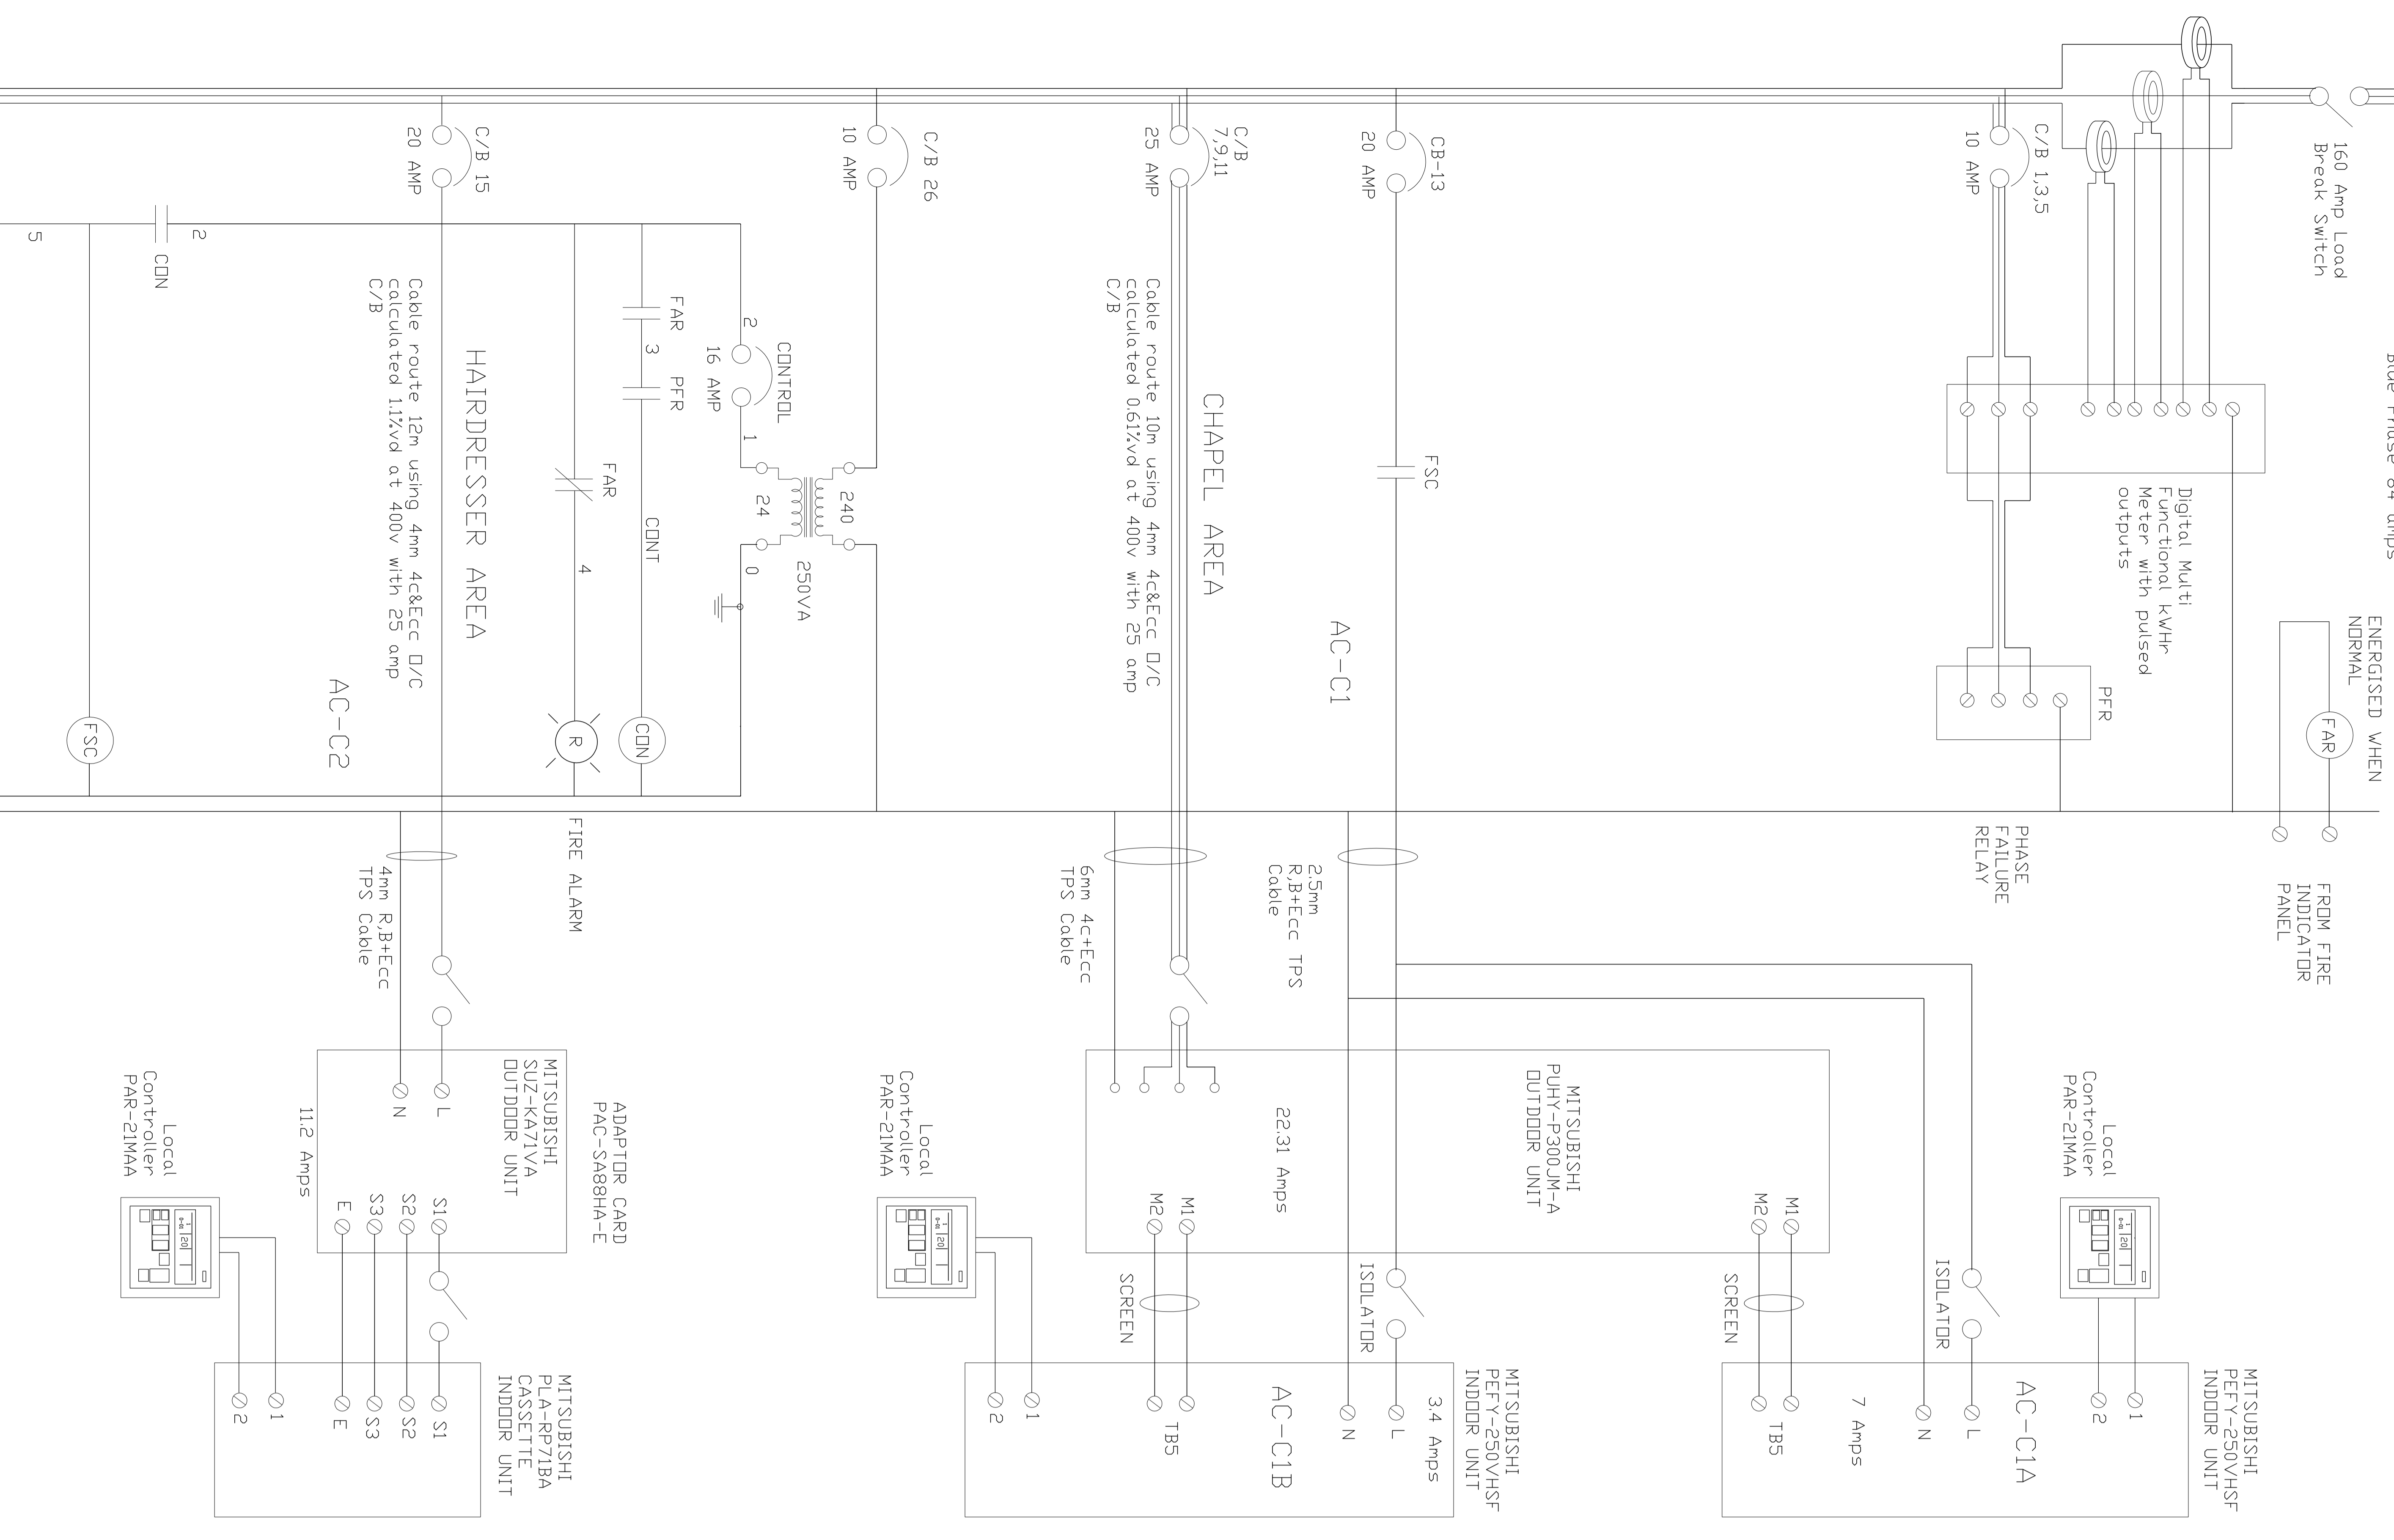

| No | ISSUE | BY DATE | No | ISSUE | BY DATE |
|----|-------|---------|----|-------|---------|
| | | | | | |

| No | BY DATE |
|----|---------|
| | |

| | | | |
|-------|-----------------|------------|---------|
| DATE | 3rd of Aug 2012 | DESIGNED | RR |
| SCALE | N/A | CHECKED | |
| DRAWN | RR | No. IN SET | 1 OF 22 |

CONTRLD & DESIGN PTY
 LTD
 52 TAYLORS LANE STRATHFIELDSAYE
 TEL. (03) 54393495 FAX. (03) 54395126
 AC/N. 086698679

PROJECT
 MERCY HEALTH & AGED CARE RESIDENCE
 STAGE 2 PROJECT SPECIMEN HILL BENDIGO

TITLE
 MECHANICAL SERVICES
 CONTRLD DRAWINGS
 CHAPEL AREA MSSB-C1
 AS BUILT DRAWINGS

PROJECT No. DRAWING No. REVISION
C-437 E1 2

CAD FILE No. BETHLEHEM_STAGE_2/Electrical_Schem