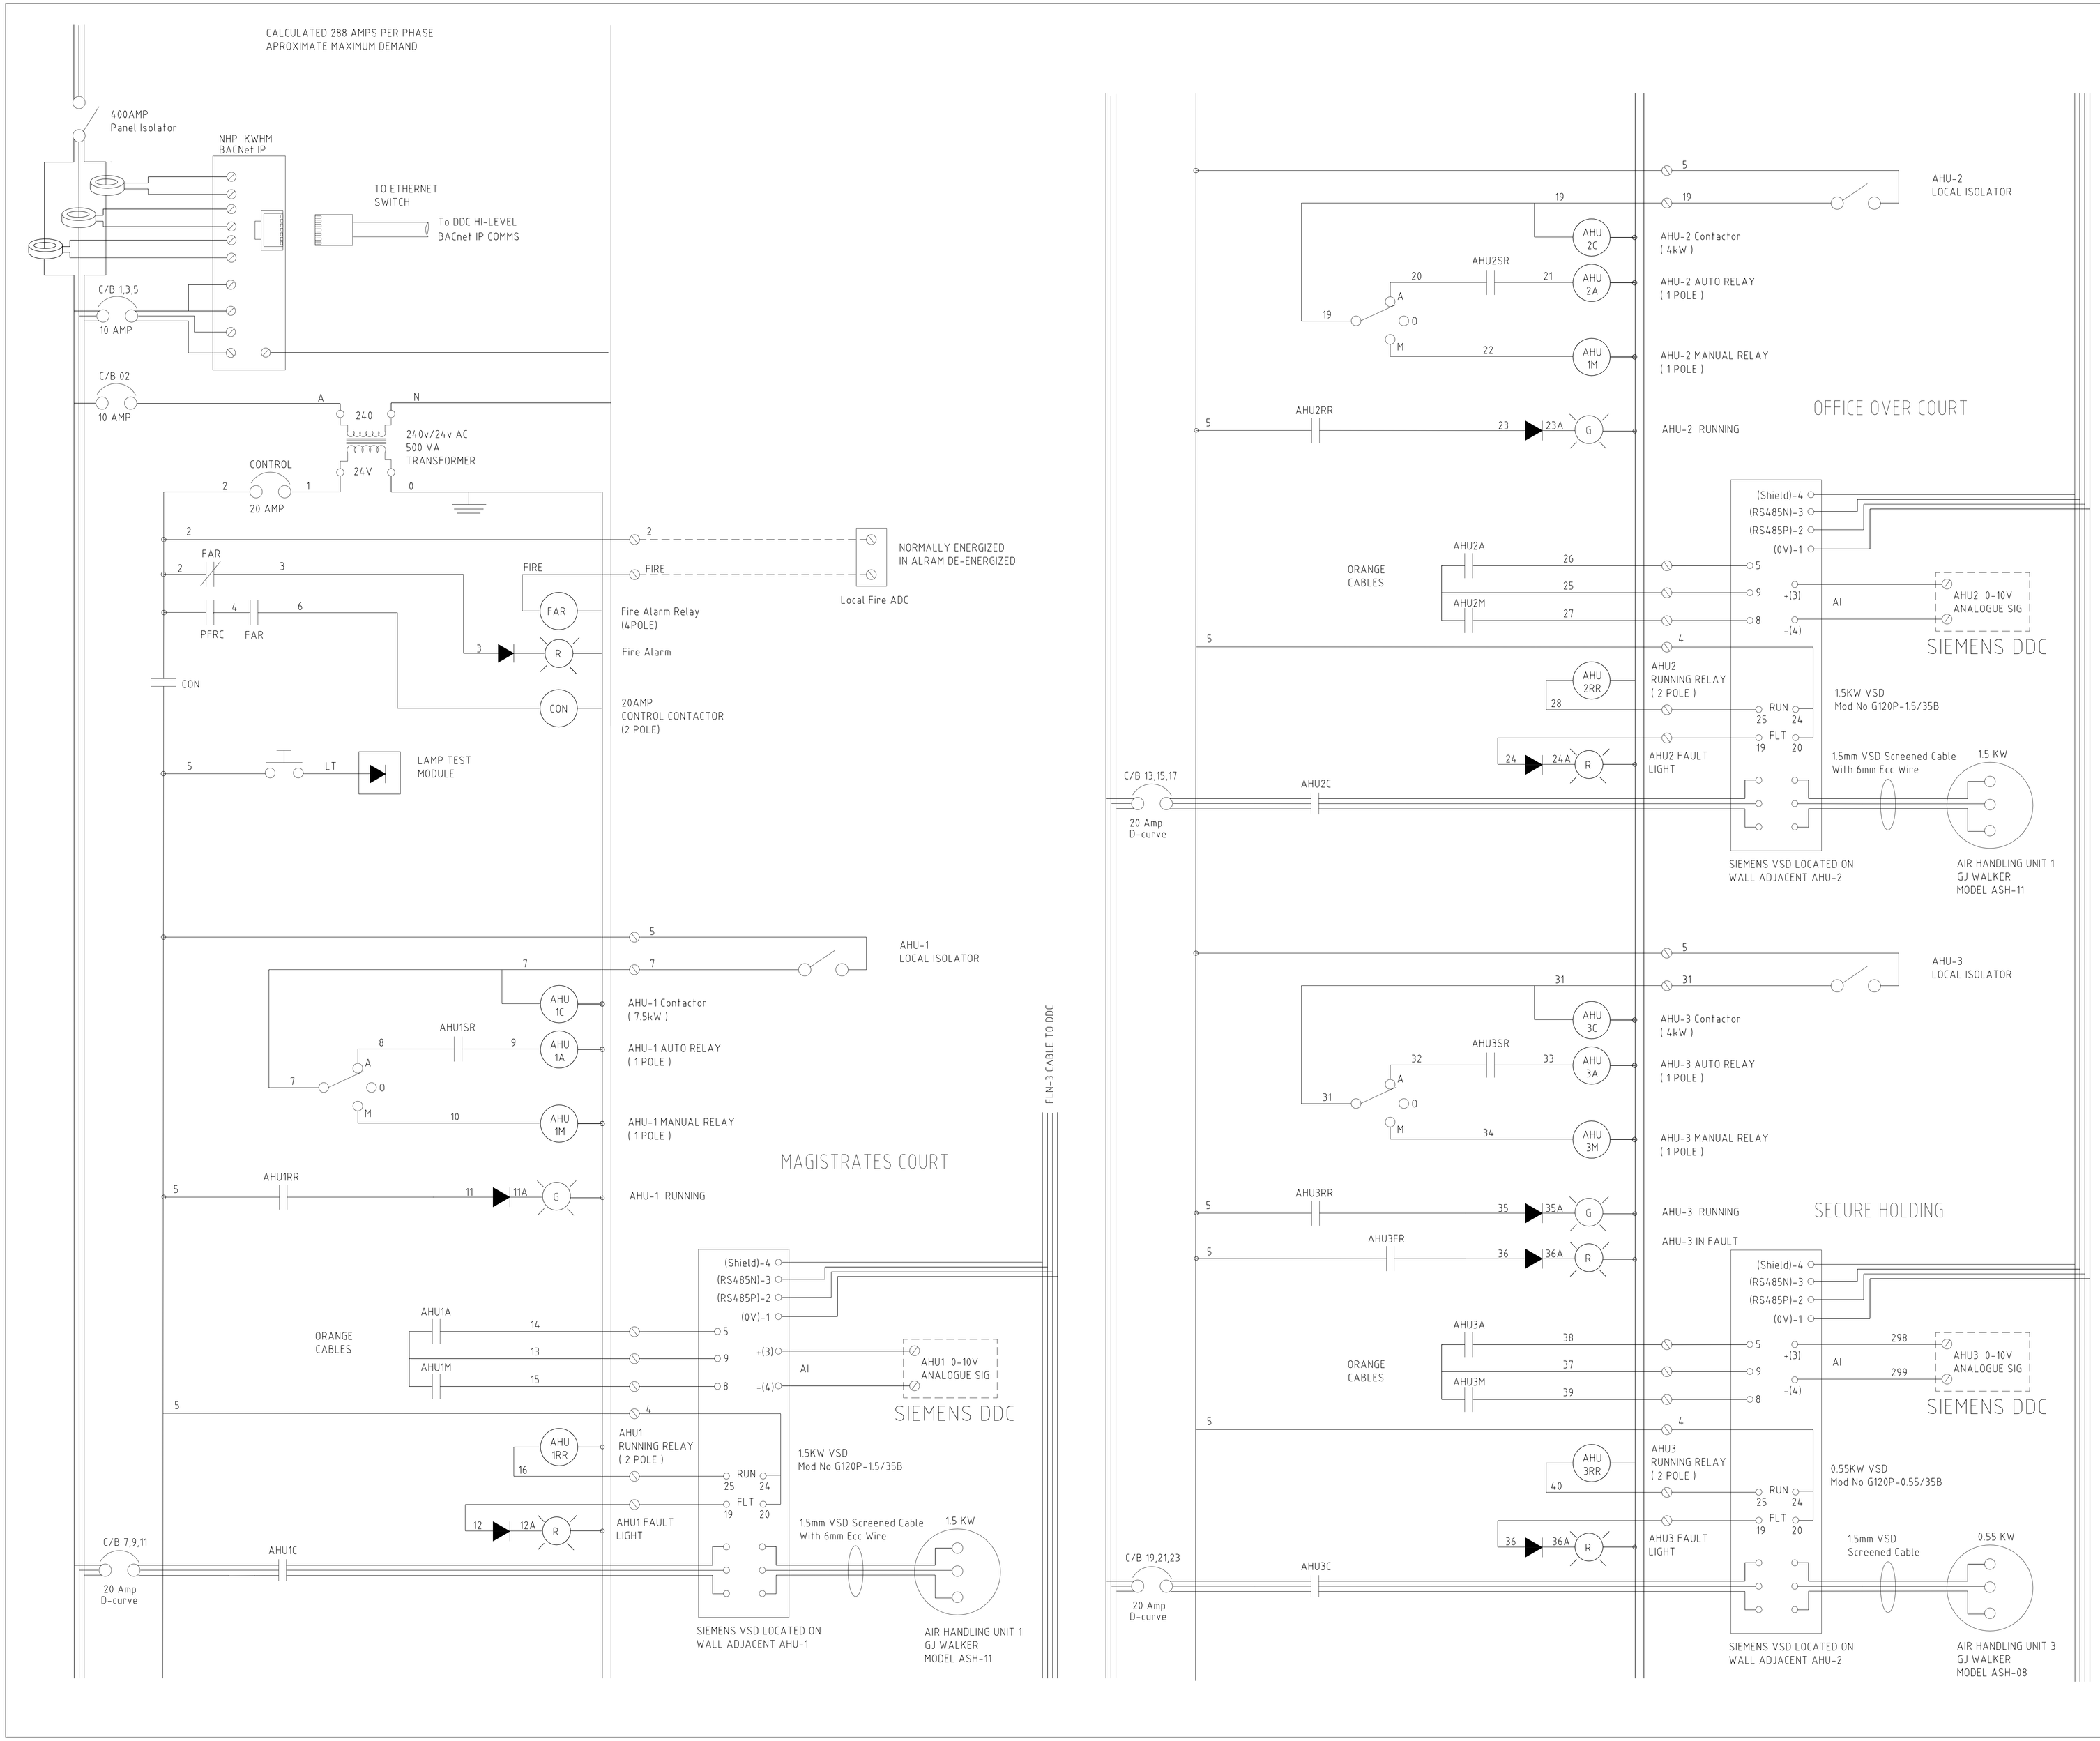

No	ISSUE	BY	DATE	No	ISSUE	BY	DATE

No		BY	DATE

DATE	24th of March '14	DESIGNED	RR
SCALE	N/A	CHECKED	
DRAWN	RR	No. IN SET	1 OF 25

CONTROL & DESIGN PTY LTD

52 TAYLORS LANE STRATHFIELDSAYE
TEL. (03) 54393495 FAX. (03) 54395126
A.C.N. 086698679

PROJECT

Department of Justice Redevelopment
Bull Street Bendigo Vic 3550

TITLE

ELECTRICAL SCHEMATICS
For Bull Street project
Mechanical Ventilation
As Built Drawings

PROJECT No.	DRAWING No.	REVISION
C-463	E1	3

CAD FILE No. Work/Drawings/Bull St/electrical schematics